BBMP

BRUHAT BANGALORE MAHANAGAR PALIKE

AS BUILT DRAWINGS

FIRST & PART BILL

IMPROVEMENTS TO ROADS, DRAINS AND OTHER DEVELOPMENTAL WORKS

PACKAGE - 08

Name of Work: Restoration and Improvements of roads at MS Palya, Aishwarya Bakery road, Giridhamanagara and surrounding areas in Ward no- 03 of Yelahanka New town Sub division.
(PACKAGE NO-08).

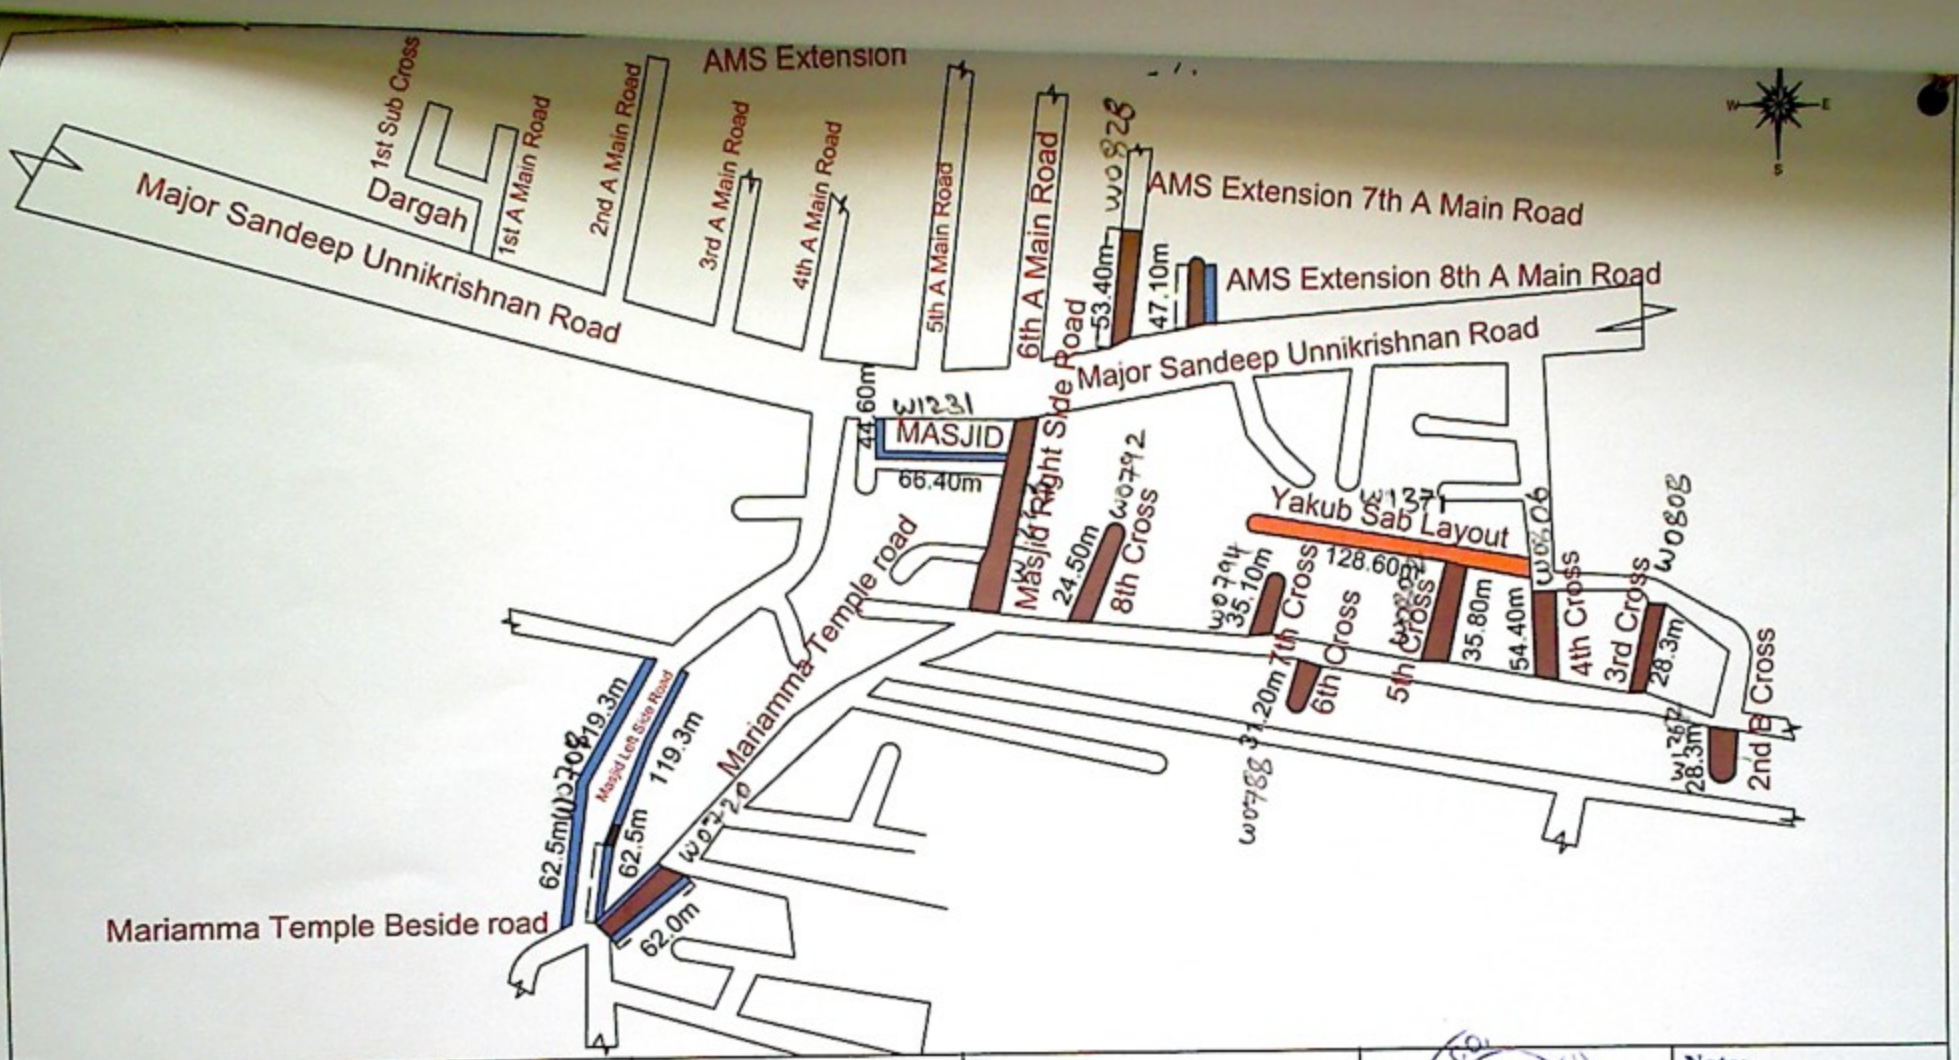

Location/Area/Ward: **Ward no 3 - Masjid Sorrounding Areas**	CLIENT: BBMP **The Executive Engineer** Yelahanka Division Bruhat Bengaluru Mahanagara Palike (BBMP) Bangalore - 560064	PMC: M/s NANDI CONSULTANTS SHIMOGA **NANDI CONSULTANTS** 1st Main, 2nd Cross, Krushinagar Shimoga-577204	CONTRACTOR: SSC Bengaluru SRI SAI Constructions	Note: FOR RCC DRAIN: FOR ASPHALT ROAD: FOR CC ROAD: FOR CULVERT:

PROJECT TITLE

Restoration and Improvements of roads at MS Palya, Aishwarya Bakery Road, Giridhamanagara and Sorrounding Areas in Ward No. 03 of Yelahanaka New Town Sub Division (Package No 08)

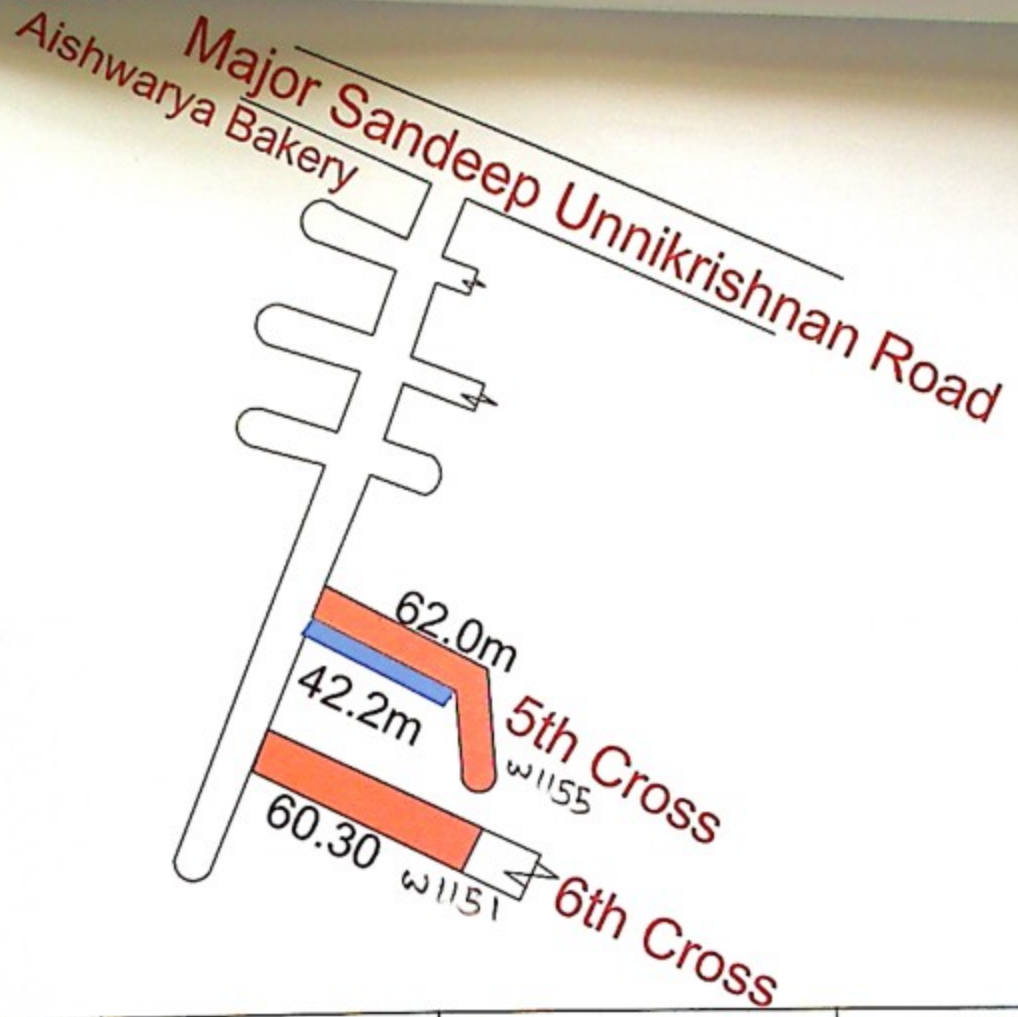

Location/Area/Ward: **Near Aishwarya Bakery - Ward 03**	CLIENT: BBMP **The Executive Engineer** Yelahanka Division Bruhat Bengaluru Mahanagara Palike (BBMP) Bangalore - 560064	PMC: M/s. NANDI CONSULTANTS **NANDI CONSULTANTS** 1st Main, 2nd Cross, Krushinagar Shimoga-577204	CONTRACTOR: SAI CONSTRUCTIONS SSC Bangalore SRI SAI Constructions	Note: FOR RCC DRAIN: FOR ASPHALT ROAD:
PROJECT TITLE Restoration and Improvements of roads at MS Palya, Aishwarya Bakery Road, Giridhamanagara and Sorrounding Areas in Ward No. 03 of Yelahanaka New Town Sub Division (Package No 08)				

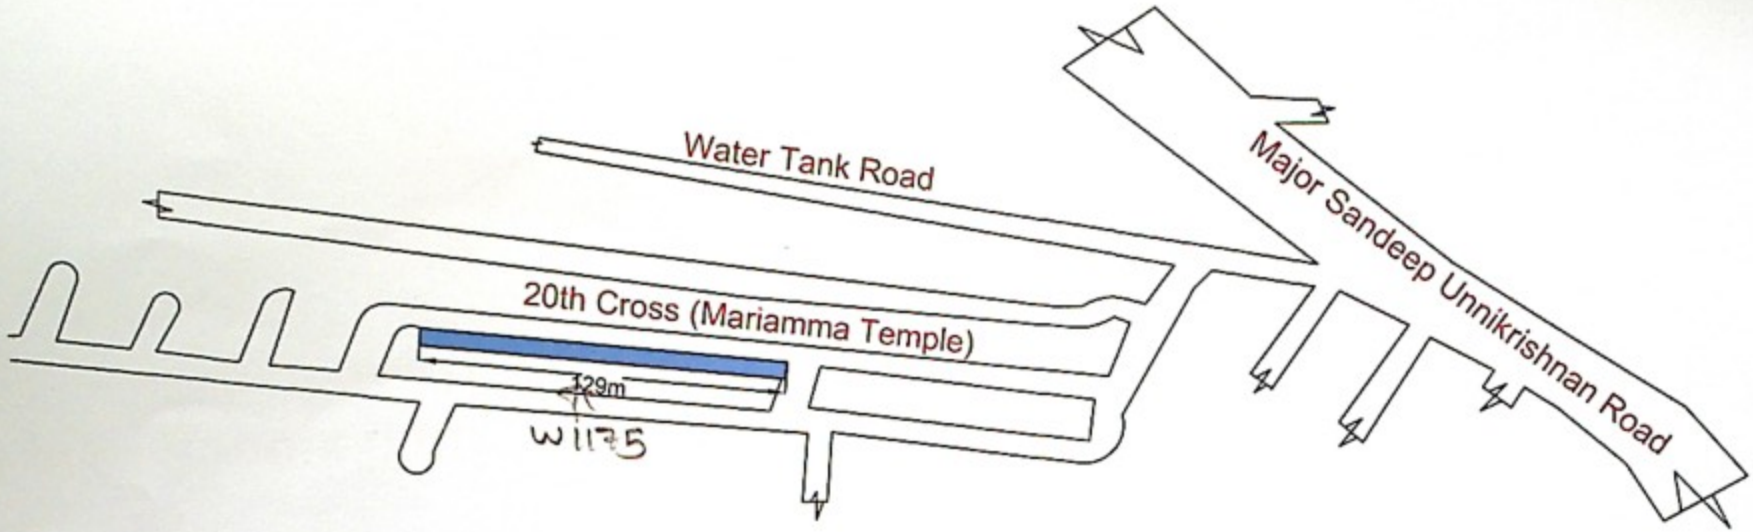

Location/Area/Ward: **Aditya Nagara near Water Tank Ward3**	CLIENT: BBMP BE	PMC: M/s. NANDI CONSULTANTS SHIVAMOGGA	CONTRACTOR: SRI SAI CONSTRUCTIONS SSC SRI SAI Constructions Bangalore	**Note:** FOR RCC DRAIN:
PROJECT TITLE Restoration and Improvements of roads at MS Palya, Aishwarya Bakery Road, Giridhamanagara and Sorrounding Areas in Ward No. 03 of Yelahanaka New Town Sub Division (Package No 08)	**The Executive Engineer** Yelahanka Division Bruhat Bengaluru Mahanagara Palike (BBMP) Bangalore - 560064	**NANDI CONSULTANTS** 1st Main, 2nd Cross, Krushinagar Shimoga-577204	ಕಾರ್ಯಪಾಲಕ ಅಭಿಯಂತರರ ಕಛೇರಿ ಯಲಹಂಕ ಉಪನಗರ ಉಪವಿಭಾಗ. ಬಿ.ಬಿ.ಎಂ.ಪಿ. ಬೆಂಗಳೂರು-106	

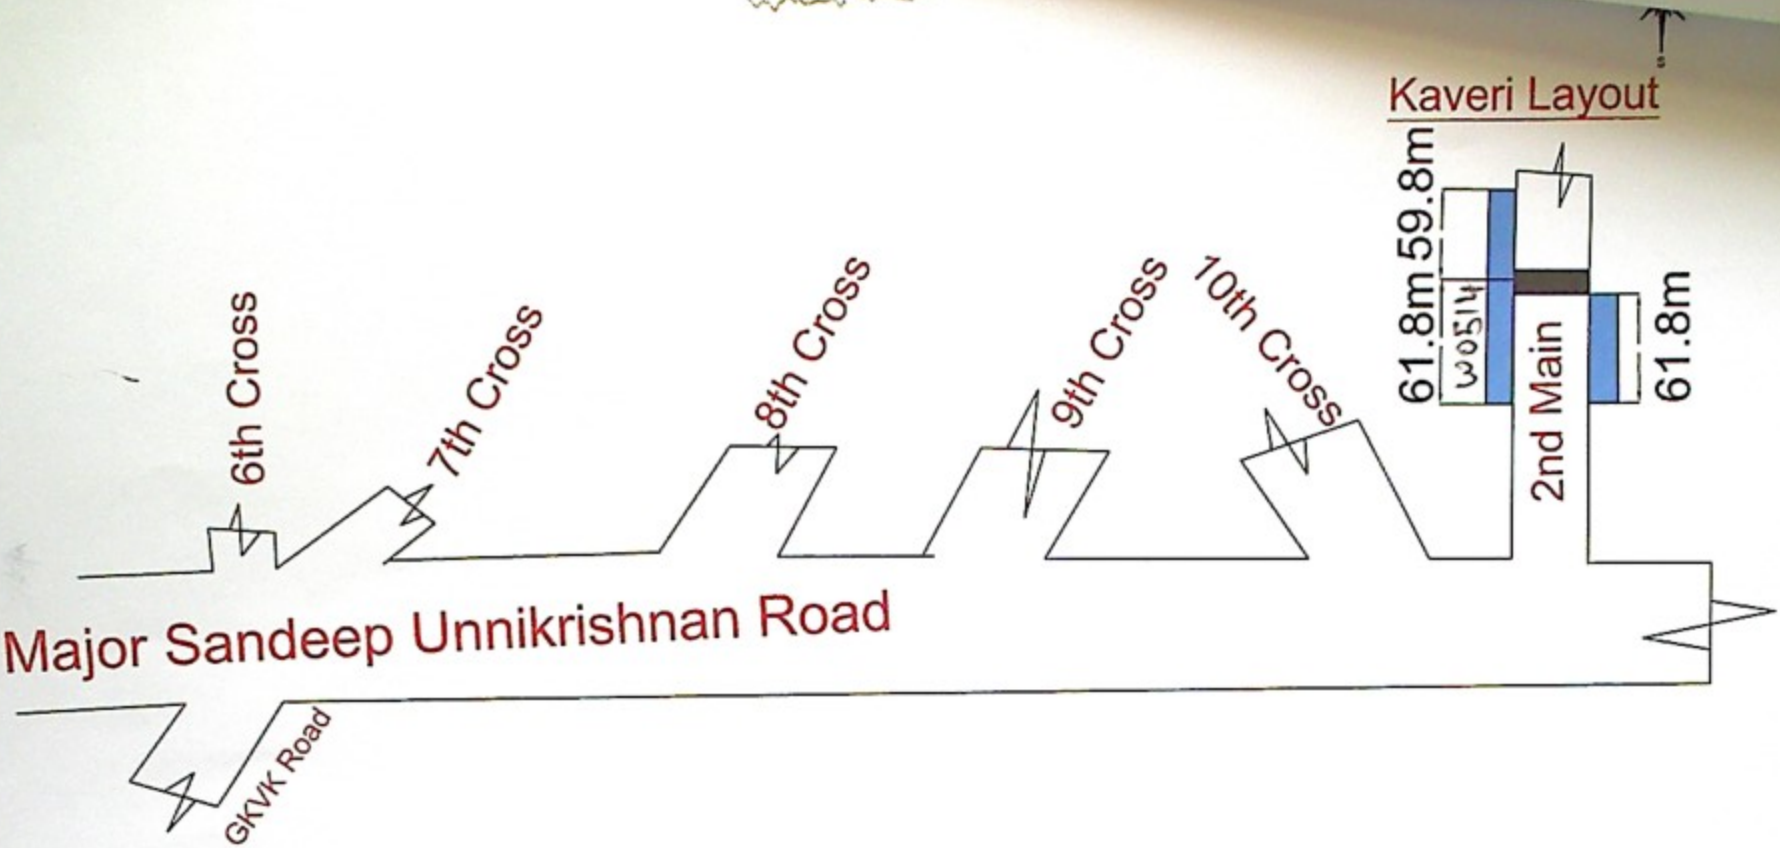

Location/Area/Ward: **Ward 3 - Kaveri Layout** PROJECT TITLE Restoration and Improvements of roads at MS Palya, Aishwarya Bakery Road, Giridhamanagara and Sorrounding Areas in Ward No. 03 of Yelahanaka New Town Sub Division (Package No 08)	CLIENT: BBMP **The Executive Engineer** Yelahanka Division Bruhat Bengaluru Mahanagara Palike (BBMP) Bangalore - 560064	PMC: M/s. NANDI CONSULTANTS **NANDI CONSULTANTS** 1st Main, 2nd Cross, Krushinagar Shimoga-577204	CONTRACTOR: SRI SAI CONSTRUCTIONS SSC Bangalore **SRI SAI Constructions** ಕಕ್ಷಾಯಕ ಕಾರ್ಯ ಪಾಲಕ ಅಭಿಯಂತರರು ಯಲಹಂಕ ಉಪನಗರ ಉಪವಿಭಾಗ. ಪ ಜ.ಎಂ.ಸಿ. ಬೆಂಗಳೂರು-10೯	Note: FOR RCC DRAIN: FOR CULVERT:

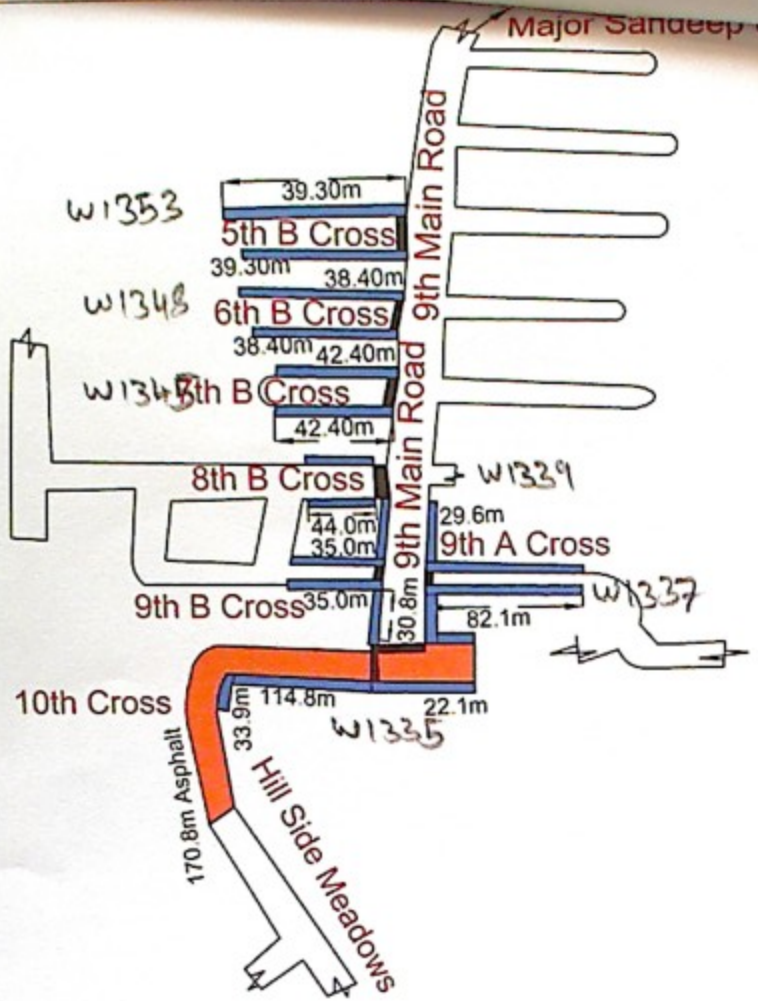

Location/Area/Ward: **Ward no 3 Aditya Nagara -1**	CLIENT:	PMC:	CONTRACTOR:	**Note:**
PROJECT TITLE Restoration and Improvements of roads at MS Palya, Aishwarya Bakery Road, Giridhamanagara and Sorrounding Areas in Ward No. 03 of Yelahanaka New Town Sub Division (Package No 08)	BBMP **The Executive Engineer** Yelahanka Division Bruhat Bengaluru Mahanagara Palike (BBMP) Bangalore - 560064	M/s NANDI CONSULTANTS **NANDI CONSULTANTS** 1st Main, 2nd Cross, Krushinagar Shimoga-577204	SRI SAI CONSTRUCTIONS Bangalore SSC **SRI SAI Constructions** ಕಾರ್ಯಪಾಲಕ ಅಭಿಯಂತರ ಯಲಹಂಕ ಉಪನಗರ ಉಪವಿಭಾಗ ಬಿ.ಬಿ.ಎಂ.ಪಿ. ಬೆಂಗಳೂರು-106	FOR RCC DRAIN FOR ASPHALT ROAD FOR CULVERT

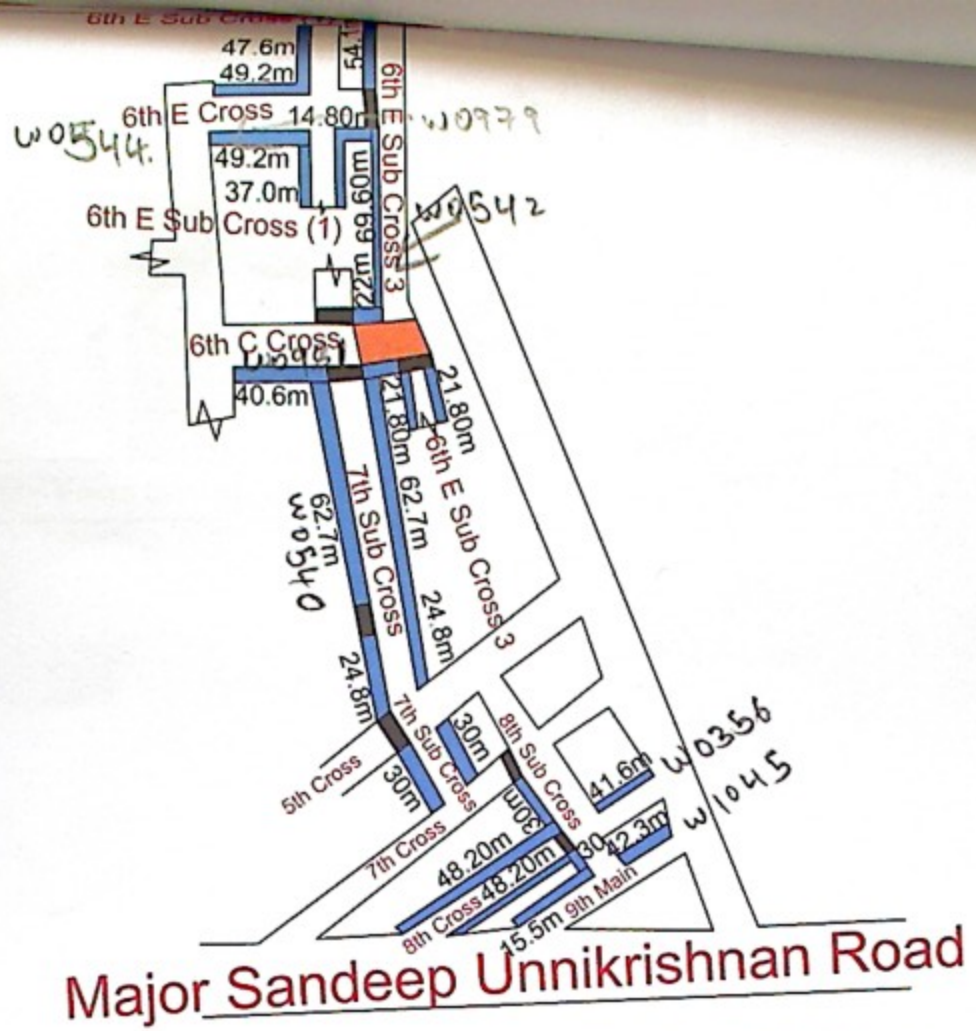

Location/Area/Ward: **Ward no 3 Aditya Nagara -2**	CLIENT: BBMP **The Executive Engineer** Yelahanka Division Bruhat Bengaluru Mahanagara Palike (BBMP) Bangalore - 560064	PMC: M/s. NANDI CONSULTANTS SHIMOGA **NANDI CONSULTANTS** 1st Main, 2nd Cross, Krushinagara Shimoga-577204	CONTRACTOR: SRI SAI CONSTRUCTIONS Bangalore SSC SRI SAI Constructions	Note: FOR RCC DRAIN FOR ASPHALT ROAD FOR CULVERT
PROJECT TITLE Restoration and Improvements of roads at MS Palya, Aishwarya Bakery Road, Giridhamanagara and Sorrounding Areas in Ward No. 03 of Yelahanaka New Town Sub Division (Package No 08)				

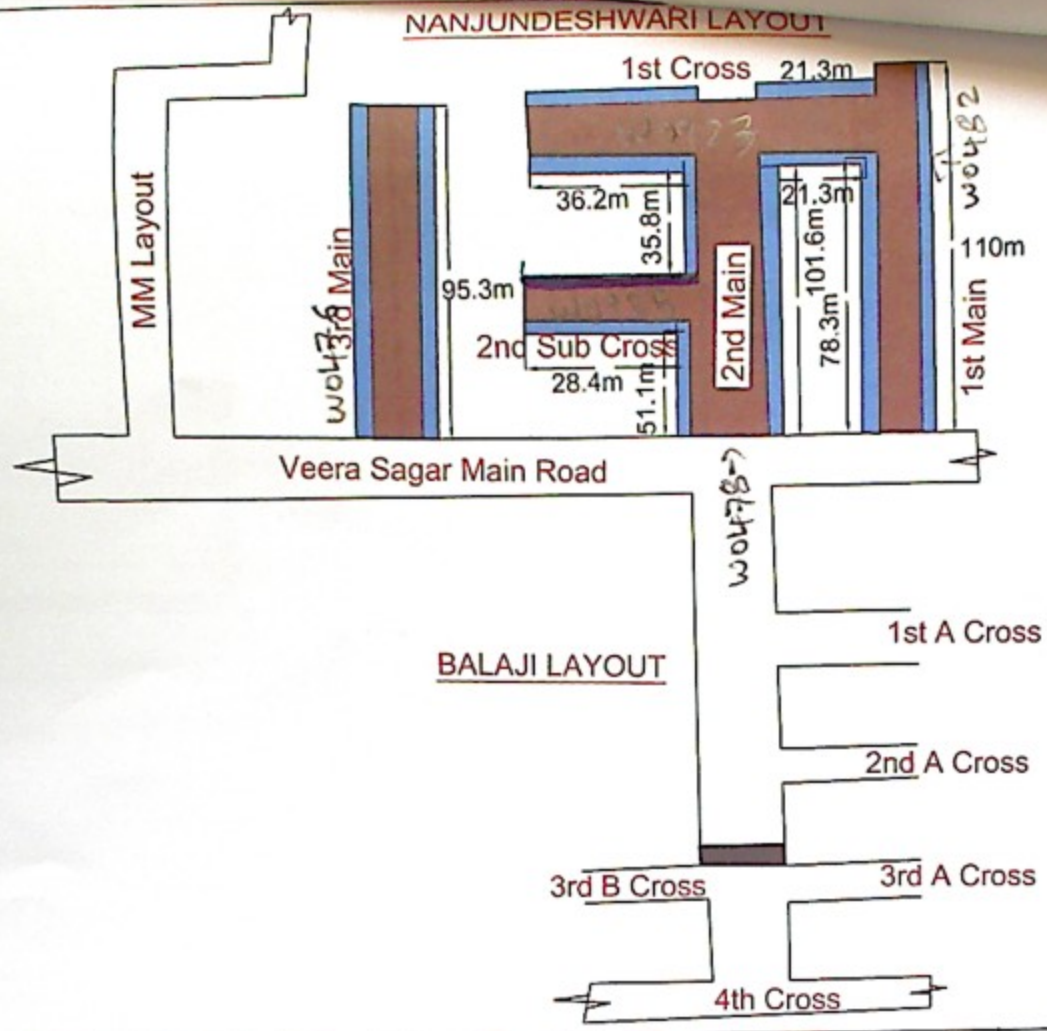

Location/Area/Ward: **Nanjundeshwari Layout - Ward 03**	CLIENT: BBMP **The Executive Engineer** Yelahanka Division Bruhat Bengaluru Mahanagara Palike (BBMP) Bangalore - 560064	PMC: M/s. NANDI CONSULTANTS SHIMOGA **NANDI CONSULTANTS** 1st Main, 2nd Cross, Krushinagar Shimoga-577204	CONTRACTOR: SRI SAI CONSTRUCTIONS SSC Bangalore **SRI SAI Constructions** ಯಲಹಂಕ ಉಪನಗರ ಉಪವಿಭಾಗ, ಬಿ.ಬಿ.ಎಂ.ಪಿ. ಬೆಂಗಳೂರು-106	Note: FOR RCC DRAIN FOR CULVERT FOR CC ROAD
PROJECT TITLE Restoration and Improvements of roads at MS Palya, Aishwarya Bakery Road, Giridhamanagara and Sorrounding Areas in Ward No. 03 of Yelahanaka New Town Sub Division (Package No 08)			

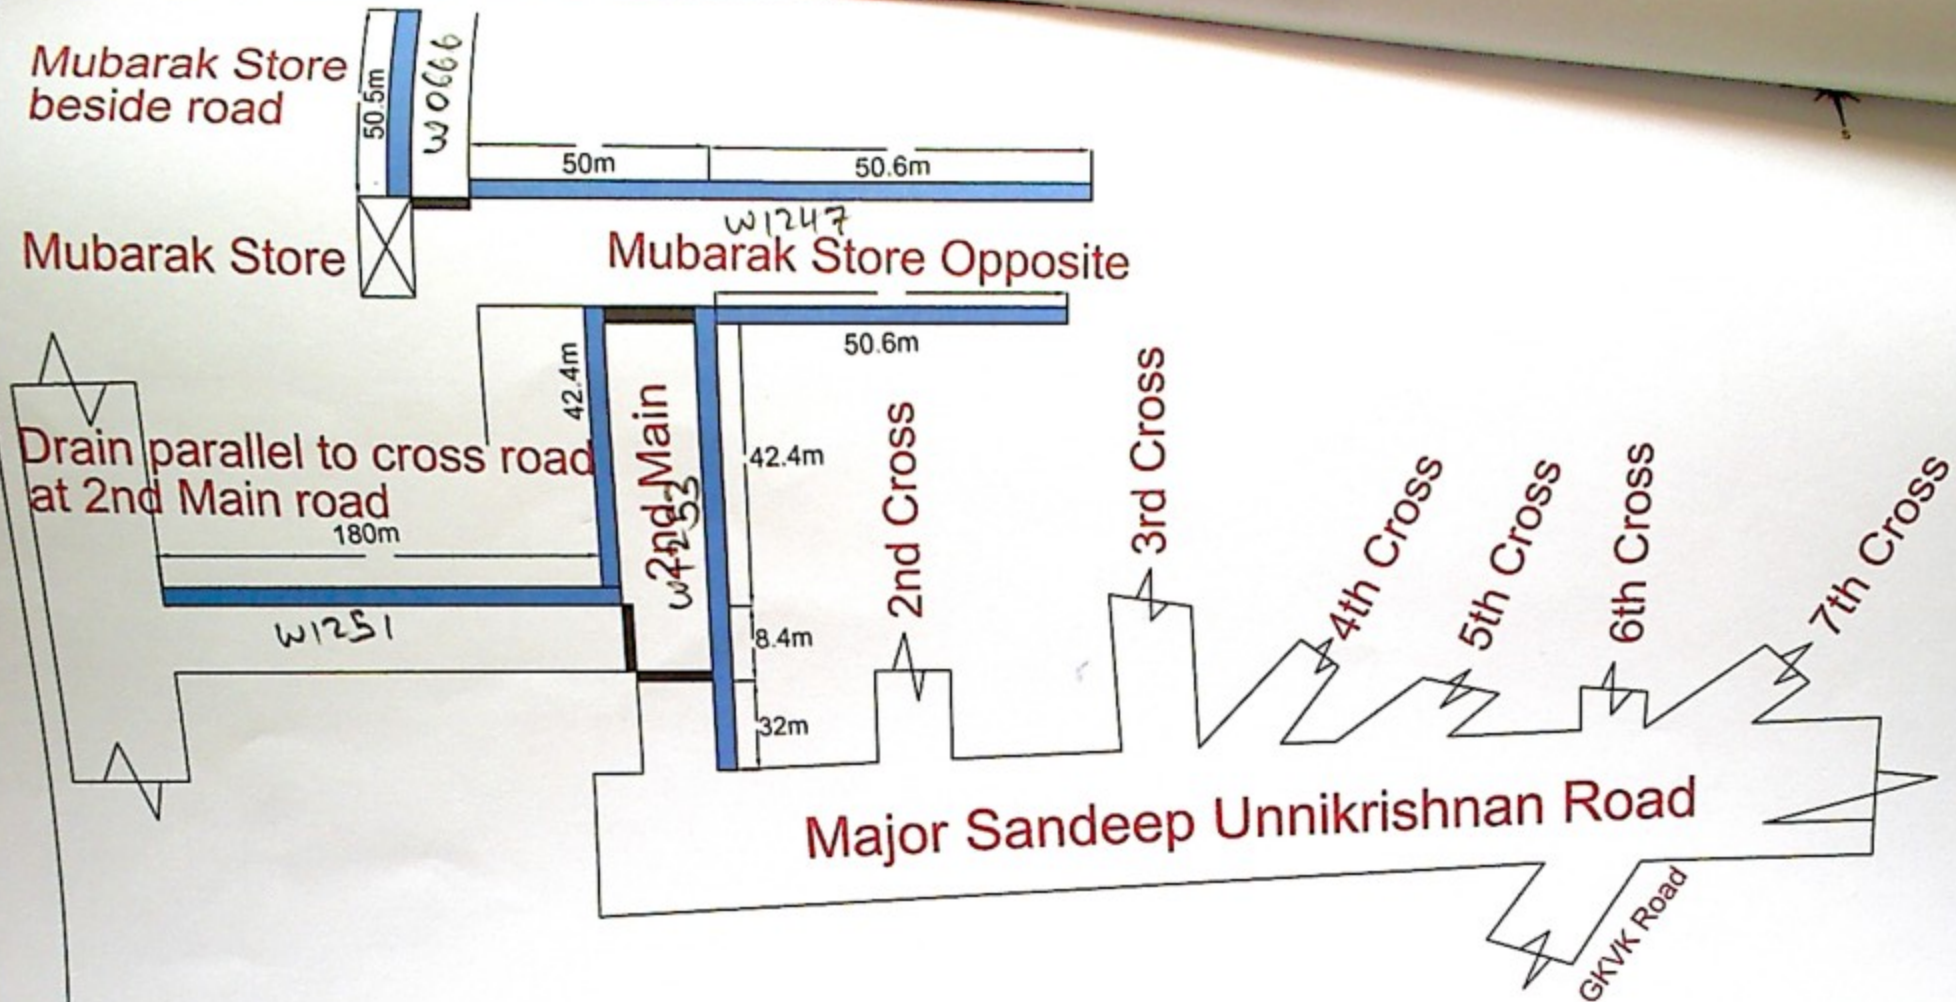

Location/Area/Ward: **Ward 3 - Bettahalli Sorrounding Areas**	CLIENT: BBMP AE **The Executive Engineer** Yelahanka Division Bruhat Bengaluru Mahanagara Palike (BBMP) Bangalore - 560064	PMC: M/s. NANDI CONSULTANTS SHIMOGA **NANDI CONSULTANTS** 1st Main, 2nd Cross, Krushinagara Shimoga-577204	CONTRACTOR: SRI SAI Constructions SSC Bangalore	Note: FOR RCC DRAIN: FOR CULVERT:
PROJECT TITLE Restoration and Improvements of roads at MS Palya, Aishwarya Bakery Road, Giridhamanagara and Sorrounding Areas in Ward No. 03 of Yelahanaka New Town Sub Division (Package No 08)				